
General Notes:

1. No dimension is to be scaled from this drawing. All Contractors must familiarise themselves with site conditions, including checking site dimensions, and must report in writing of any discrepancies with the information depicted in this drawing or the specifications. The Contractor shall obtain further instructions from C B Richard Ellis prior to proceeding with the affected elements.
2. This drawing is to be read in conjunction with other related drawings, Specifications, Schedules and Bill of Quantities produced and issued by C B Richard Ellis and other involved parties for this project. The Contractor shall advise in writing of any inconsistences or contradictions of any of the information contained therein and shall obtain further instructions from C B Richard Ellis prior to proceeding.
3. Contractors to advise on suitability of all details and to ensure structural integrity, stability and strength of all construction for intended the performance.
4. Contractors to ensure that all specified and implied materials, fixtures and fittings are fabricated and installed in accordance with their manufacturers' recommendations. Contractor is responsible for obtaining all relevant manufacturers' data and related information.
5. Contractors to ensure that all materials and construction complies with Local Authorities, Building Regulations, Environmental Health, Planning, CDM and any other relevant statutory requirements.
6. Contractors to ensure all specified materials, fixtures and fittings are procurred to meet all aspects of the project programme and must advise C B Richard Ellis if any items will not be available in sufficient time and to request further instructions.

Copyright notice:
This and all other documents authored by C B Richard Ellis and all information and concepts both depicted and implied therein are the sole property of CB Richard Ellis. Reproduction or transmission in any form is strictly forbidden unless prior permission in obtained in writing from CB Richard Ellis. Construction based on the depicted information at any time or location not referred to this project is strictly forbidden unless prior permission is obtained in writing from CB Richard Ellis.

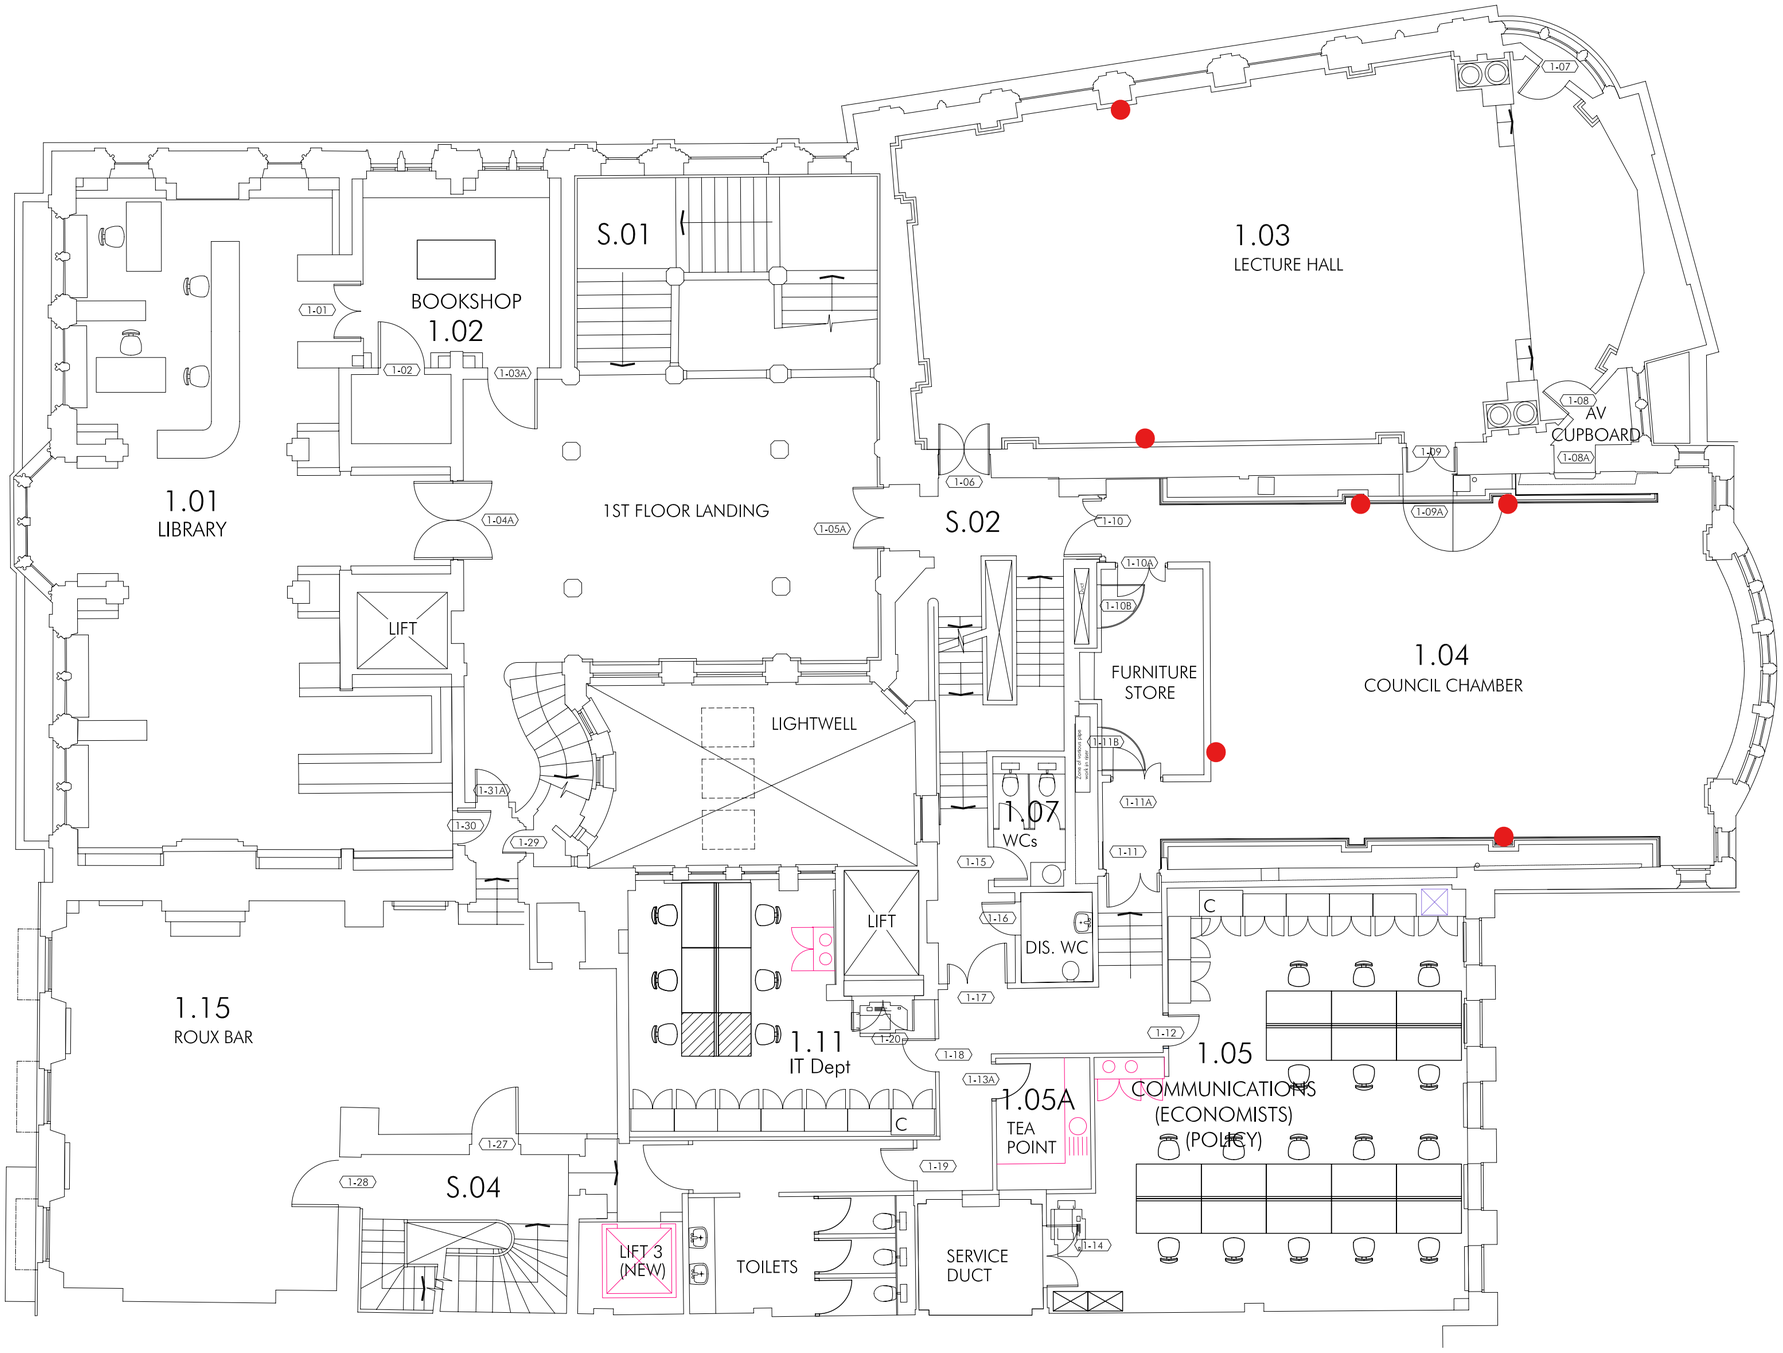

CBRE
CB RICHARD ELLIS

CB Richard Ellis Limited, St Martins Court, 10 Paternoster Row, London EC4M 7HP
Switchboard : 0207 182 2000 Fax : 0207 182 3007 Web : www.cbre.com

Project:	ROYAL INSTITUTION OF CHARTERED SURVEYORS
Address:	12 GREAT GEORGE STREET LONDON SW1
Drawing:	FIRST FLOOR AS BUILT PLAN
Date:	19.01.2011 Project No: 267844
Scale:	1:100@A2 Alt Scale: 1:200@A3
Drawn:	PH Checked: RS

Discipline	Series No.	Dwg. No.	Rev. No.
A	AB	01	-

Project Status: AS BUILT

Rev	Date	Revision Description	Int.	Checked
-	00/00/00	-	-	-